

BRAZORIA COUNTY ENGINEERING DEPARTMENT

REVIEWED: Jorge Reyna DATE 6-8-22

DEVELOPMENT COORDINATOR

APPROVED: Matthew Tanks DATE 05/09/22

COUNTY ENGINEER

APPROVED BY BRAZORIA COUNTY DRAINAGE DISTRICT #5

Lee Walden, P.E. DATE 6/6/22

KERRY OSBURN
VICE PRESIDENT

Brandon M. Doleton DATE 6/2/22

SECRETARY/TREASURER

JARROD ADEN
DISTRICT ENGINEER

BCDD 5 REF ID #: B220019.
NOTE: PROJECT FIELD STARTUP WILL START WITHIN 365 CALENDAR DAYS FROM DATE SHOWN.
CONTINUOUS AND REASONABLE FIELD SITE WORK IS EXPECTED.

BRAZORIA COUNTY ENGINEERING DEPARTMENT PLANS OF PROPOSED ROADWAY IMPROVEMENT

BRAZORIA COUNTY PROJECT NUMBER: XXXX


COUNTY ROAD 52 BRAZORIA COUNTY

LIMITS: FROM CR 48 TO UNIT NO. 319-00-00

TOTAL LENGTH OF PROJECT = 3,407.73 = 0.65 MI.



DESIGN SPEEDS = 30 MPH
FUNC. CLASS = MAJOR ARTERIAL

TYPE OF WORK: PAVEMENT CONSTRUCTION
CONSISTING OF PAVEMENT, DRAINAGE, AND
PAVEMENT MARKINGS AND SIGNING

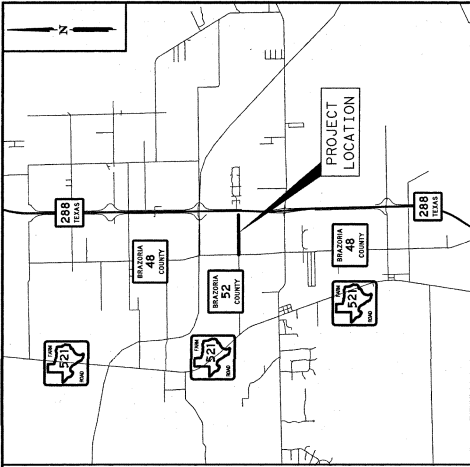

VICINITY MAP
SCALE: 1" = 15,000'

 RECORD DRAWINGS

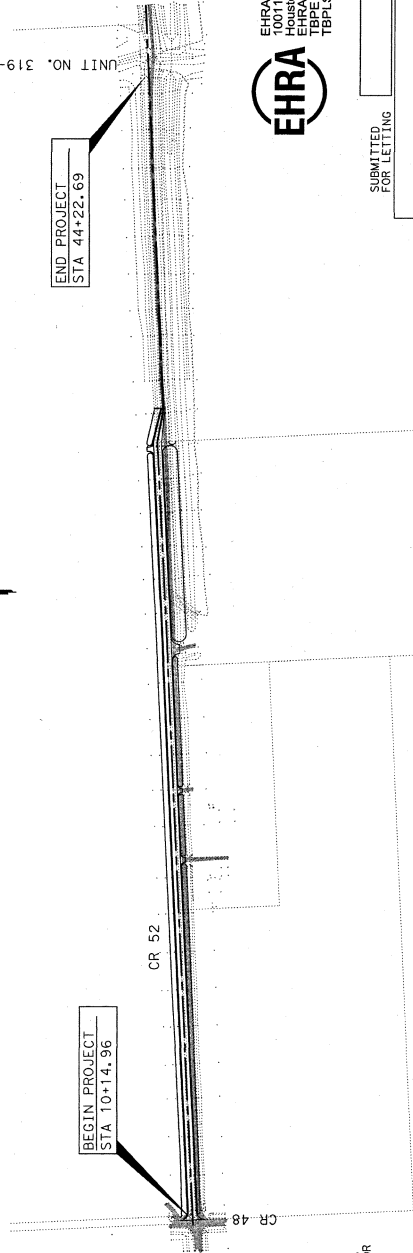

STREET NAME CR 52
ROW WIDTH 60'
LENGTH (ft) 3407.73'
LENGTH (mi) 0.65

PROJECT LAYOUT
SCALE: NTS



05-18-2022

NOTE:
REGULATIONS ADOPTED BY THE TEXAS DEPARTMENT OF TRANSPORTATION,
NOVEMBER 2004, AND THE CONTRACT PROVISIONS DATED AND DATED
FOLLOWS SHALL GOVERN ON THIS PROJECT. SPECIAL LABOR PROVISIONS FOR
STATE PROJECTS (0000-394)

WORK WAS COMPLETED ACCORDING
TO THE PLANS AND CONTRACT.

Signature of Registrant & Date



P-4261

SUBMITTED
FOR LETTING

P. E.

PROJECT MANAGER
EHRA