

DEVELOPER: LAND TEXAS
STANDARD INDUSTRIAL PARK C
2450 FONGREN ROAD, SUITE 210
HOUSTON, TEXAS 77063
(713) 285-8702

CONSTRUCTION OF WATER, SANITARY, DRAINAGE, AND PAVING FACILITIES FOR

SIERRA VISTA SEC. 2

BRAZORIA COUNTY M.U.D. NO. 32
BRAZORIA COUNTY, TX
PROJECT NO. 600.001005.00

INDEX OF SHEETS


SHEET NO. DESCRIPTION

- | | |
|----|--|
| 1 | TITLE SHEET & SHEET INDEX |
| 2 | GENERAL NOTES |
| 3 | WATER AND SANITARY OVERALL |
| 4A | DRAINAGE OVERALL- NE |
| 4B | DRAINAGE OVERALL- NW |
| 4C | DRAINAGE OVERALL- S |
| 5 | DRAINAGE CALCULATIONS |
| 6 | GRADING PLAN |
| 7 | STORM WATER POLLUTION PREVENTION PLAN |
| 8 | P&P - SIERRA VISTA BLVD. (STA 6+00 TO 16+50) |
| 9 | P&P - SIERRA VISTA BLVD. (STA 16+50 TO 24+50) |
| 10 | P&P - SIERRA VISTA BLVD. (STA 24+50 TO STA 33+50) |
| 11 | P&P - THUNDERBOLT PEAK DR. (STA 0+50 TO STA 11+00) |
| 12 | P&P - HUMPHREYS GREEN DR. (STA 0+50 TO STA 7+50) |
| 13 | P&P - RED SLATE DR. (STA 11+50 TO STA 18+50) |
| 14 | P&P - RITTER RUN DR. (STA 0+50 TO STA 11+50) |
| 15 | P&P - AGASSIZ DR. (STA 0+00 TO STA 7+40) |
| 16 | P&P - MATTERHORN DR. (STA 7+40 TO 11+90) & BASELINE A |
| 17 | P&P - LANGLEY DR. (STA 11+90 TO STA 16+00) |
| 18 | P&P - SPLIT MOUNTAIN DR. (STA 0+00 TO 6+00) |
| 19 | P&P - MUIR PEAK DR. (STA 0+00 TO STA 8+00) |
| 20 | P&P - BANNER PEAK DR. (STA 8+00 TO STA 12+00) |
| 21 | P&P - SILL PRAIRIE DR. (STA 12+00 TO STA 20+00) |
| 22 | TRAFFIC SIGNAGE & PAVEMENT MARKINGS |
| 23 | SIERRA VISTA BIKE LANE |
| 24 | CITY OF IOWA COLONY STANDARD DETAILS - WATER (SHEET 1 OF 12) |
| 25 | CITY OF IOWA COLONY STANDARD DETAILS - WATER (SHEET 2 OF 12) |
| 26 | CITY OF IOWA COLONY STANDARD DETAILS - SAN. SEW. (SHEET 3 OF 12) |
| 27 | CITY OF IOWA COLONY STANDARD DETAILS - SAN. SEW. (SHEET 4 OF 12) |
| 28 | CITY OF IOWA COLONY STANDARD DETAILS - SAN. SEW. (SHEET 5 OF 12) |
| 29 | CITY OF IOWA COLONY STANDARD DETAILS - SAN. SEW. (SHEET 6 OF 12) |
| 30 | CITY OF IOWA COLONY STANDARD DETAILS - STM. SEW. (SHEET 7 OF 12) |
| 31 | CITY OF IOWA COLONY STANDARD DETAILS - SWPPP (SHEET 8 OF 12) |
| 32 | CITY OF IOWA COLONY STANDARD DETAILS - PAVING (SHEET 9 OF 12) |
| 33 | CITY OF IOWA COLONY STANDARD DETAILS - PAVING (SHEET 10 OF 12) |
| 34 | CITY OF IOWA COLONY STANDARD DETAILS - PAVING (SHEET 11 OF 12) |
| 35 | CITY OF IOWA COLONY STANDARD DETAILS - PAVING (SHEET 12 OF 12) |
| 36 | DRAINAGE SERVICE AREA MAP |

CONTRACTOR SHALL NOTIFY THE CITY OF IOWA COLONY C/O ADICO, LLC (DINH HO, P.E.
AT 832-895-1093, DINH@ADICO-LLC.COM), 48 HOURS BEFORE COMMENCING WORK.

MANHARD CONSULTING, LTD. IS NOT RESPONSIBLE FOR THE SAFETY OF ANY PARTY AT OR ON THE
CONSTRUCTION SITE. SAFETY IS THE SOLE RESPONSIBILITY OF THE CONTRACTOR AND ANY OTHER PERSON OR
ORGANIZATION. THE USER OF THIS DRAWING AGREES TO HOLD THE CITY OF IOWA COLONY HARMLESS FOR
THE JOB SITE SAFETY OF PERSONS ENGAGED IN THE WORK OR THE MEANS OR METHODS OF CONSTRUCTION.

PROJECT LOCATION

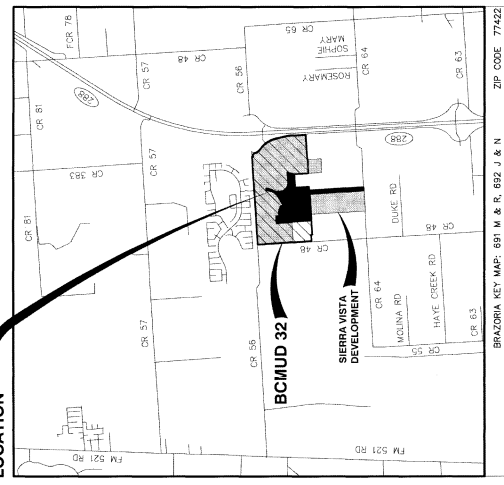

LOCATION MAP

N.T.S.

AS-BUILT
BY: ABROCKMAN DATE: MAY 04, 2018

ONE-CALL NOTIFICATION SYSTEM
CALL BEFORE YOU DIG!!
(713) 223-4607 (In Houston)
(New Schedule Number Outside Houston)
1-800-560-6005

BRAZORIA COUNTY DRAINAGE DISTRICT NO. 5
PLAN APPROVAL - VALID FOR 1 YEAR
Michael B. B. 5/1/17
Michael B. B. 5/1/17
Michael B. B. 5/1/17
DATE: 5/1/17

Manhard
CONSULTING

2400 Technology Forest Blvd, Suite 500, The Woodlands, TX 77381, ph: 832.895.2000, f: 832.895.2002, manhard.com
Professional Engineers • Environmental Scientists • Landscape Architects • Planners
Construction Managers • Ties Board of Professional Engineers Registration No. F-18141

